


EXAMPLE AS-BUILT PLOT PLAN

LOT 205

TOWNSHIP SUBDIVISION NAME

NOTE:  
TWO TREES REQUIRED  
PER WASHINGTON TWP.  
ORDINANCE #133-181.708  
SEC. 707.

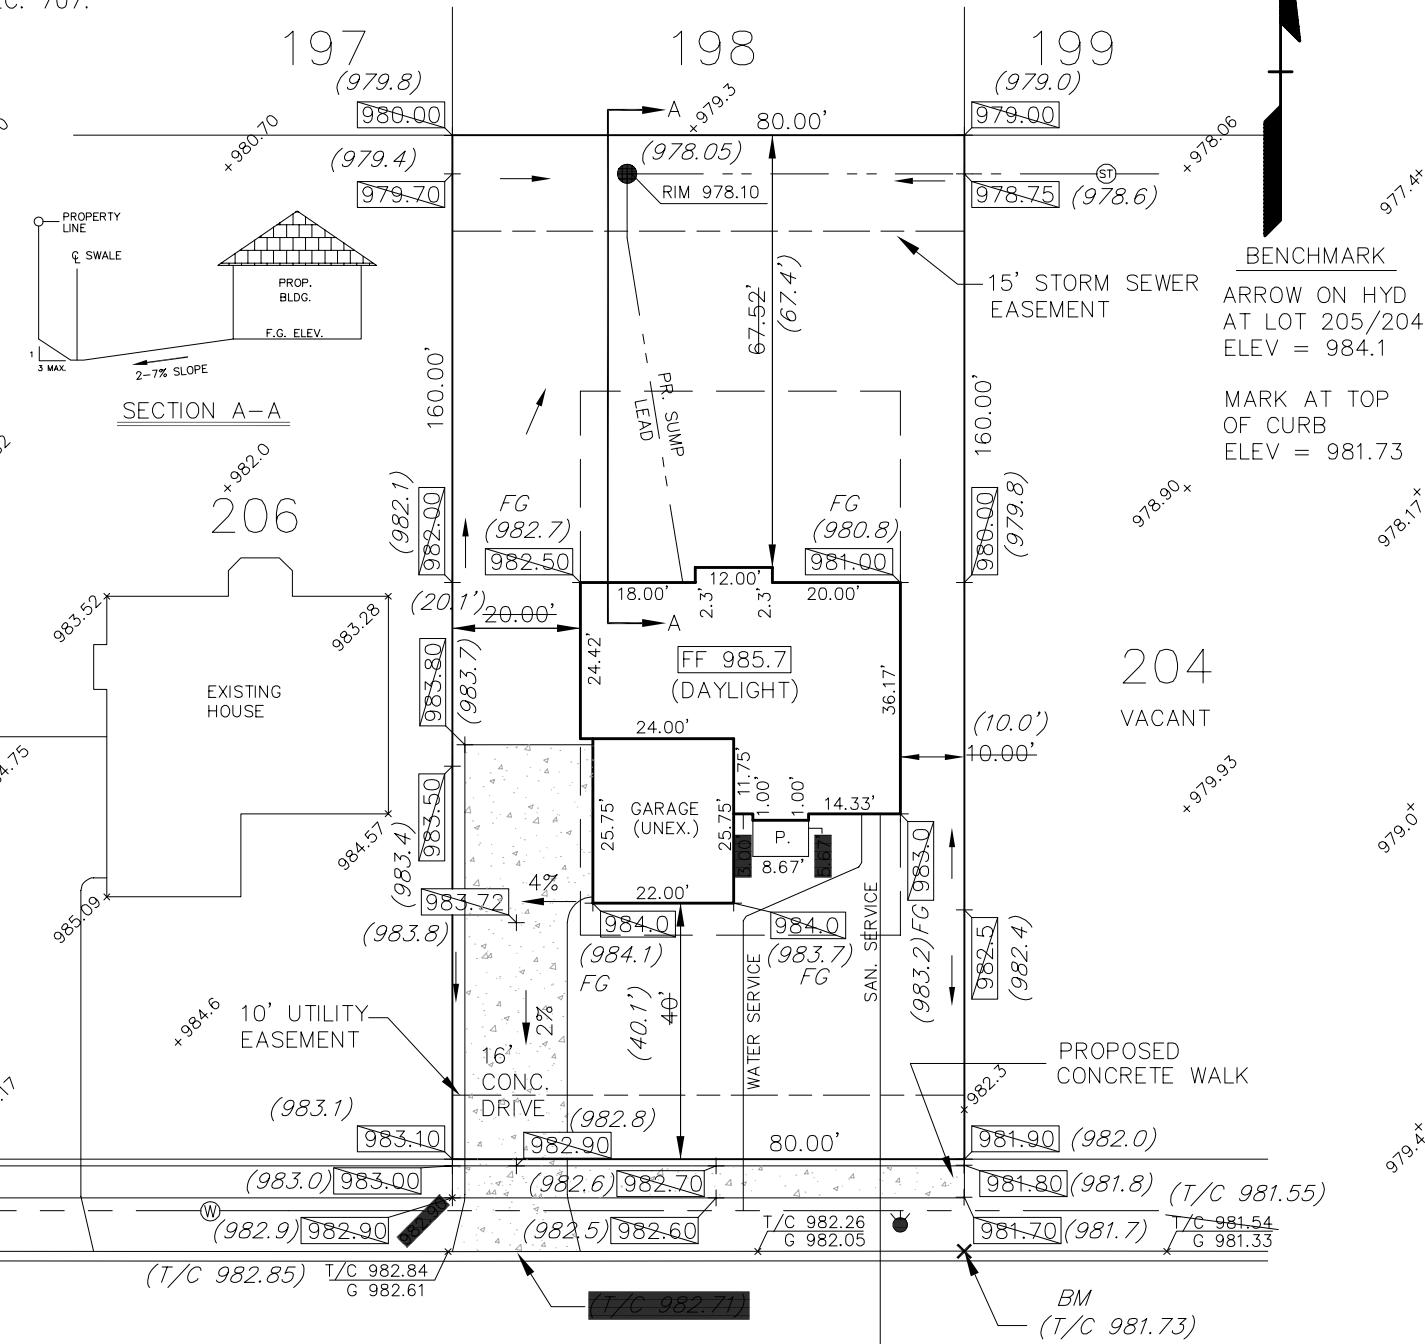

ANY STREET (60' WIDE ROW)

FG - FINISH GRADE  
BL - BRICK LEDGE

LEGEND

- 700.00 EXISTING ELEVATION
- 700.00 PROP. ELEVATION
- (700.00) AS-BUILT ELEV/DIMENSION
- ⊙ STORM MANHOLE
- ⊕ STORM CATCH BASIN
- ⊙ SANITARY MANHOLE
- HYDRANT
- ⊙ GATE VALVE IN WELL

NOTE:  
THIS AS-BUILT SURVEY WAS  
COMPLETED ON MAY 16, 2004  
FOR FINAL GRADES \*

NOTE:  
SOIL EROSION CONTROLS SHALL BE INSTALLED AND MAINTAINED  
THROUGHOUT CONSTRUCTION UNTIL THE TIME PERMANENT  
EARTH STABILIZATION OR VEGETATION HAS BEEN ESTABLISHED.

FINISH FLOOR ELEV. = 985.70 (985.68)  
GARAGE FLOOR ELEV. = 984.20 (984.25)  
BASEMENT FLOOR = 977.20 (986.9)

REV: 7-29-05  
REV: 6-29-03

CLIENT:  
**SMITH DEVELOPMENT**  
1234 ONE MILE ROAD, SUITE 500  
WEST TOWN, MICHIGAN 48000

SCALE: 1"=30'  
JOB No: WAG200  
DATE: 5-27-03  
DWG. No: 1

DESIGN  
ENGINEER'S  
FIRM NAME  
Their Address  
City and Zip code  
Their Phone Number

\* IF PRE-GRADING DRAWING, NOTE AS-BUILT  
BRICKLEDGE GRADES INSTEAD OF FINISH GRADES.